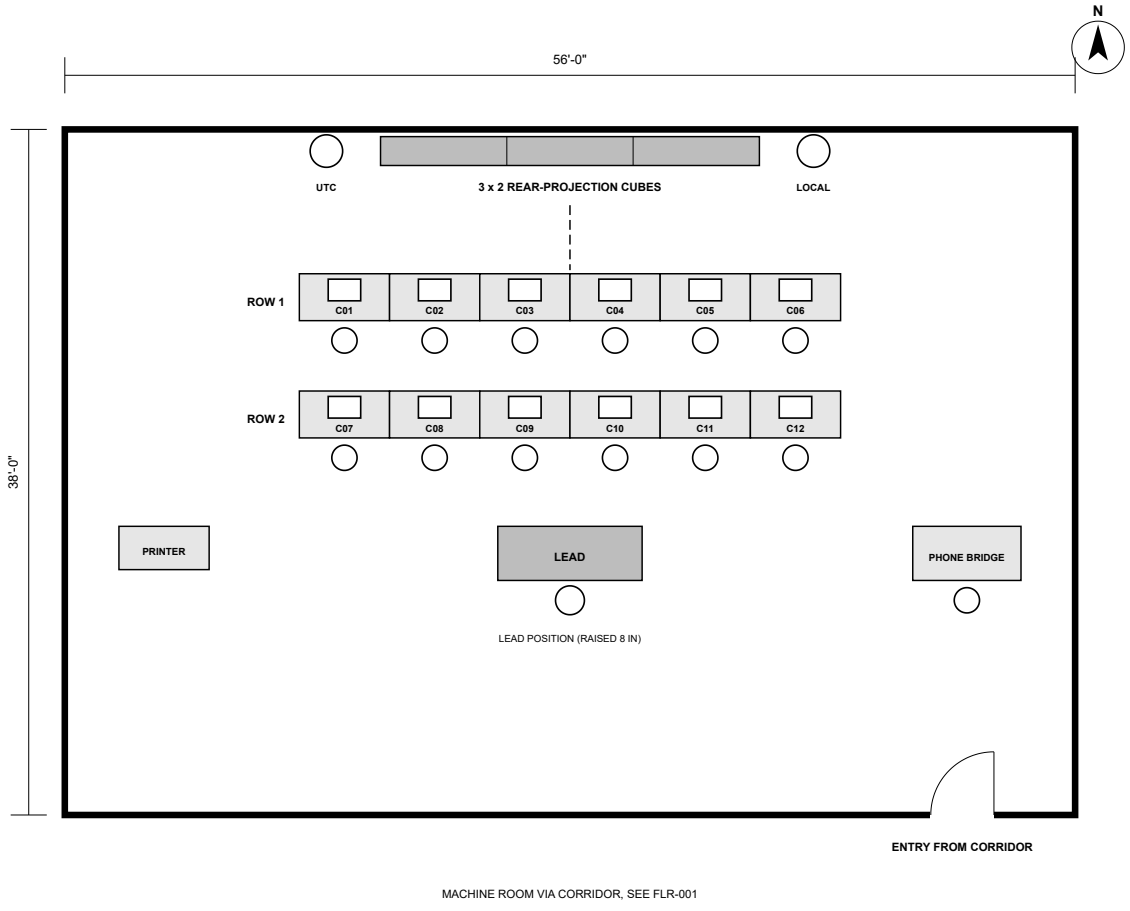


PLAN VIEW // SCALE: 1/8 IN = 1 FT (NOMINAL)

SUPERSEDED
SEE REGISTER FOR CURRENT REVISION

REVISIONS

REV	DATE	DESCRIPTION	BY	APPR
B	15 JUN 1998	As built for commissioning. Phone bridge position added.	MK	MV
A	16 FEB 1998	Initial issue. Two console rows, operator workstations with 21 in monitors, 3 x 2 rear-projection video wall, Lead position, wall clocks UTC and local.		

NOTES

1. 12 operator consoles in two rows facing the display wall, numbered C01-C12 from the front left.
2. Monitors: 21 IN CRT (one per console).
3. Display wall: 3 x 2 REAR-PROJECTION CUBES.
4. Lead position at the rear on an 8 in platform with a clear sight line to the wall.
5. Phone bridge position at the rear right.
6. Wall clocks: UTC left of the display wall, local time right.
7. Entry keyed, badge worn on the floor. See SEC-001.
8. Console power from the UPS (PWR-001). Watch floor network segment per NET-001.
9. Site B watch floor per SITE-B-001.

LEGEND

- Console / furniture
- Display wall / wall equipment
- Operator seat
- Sight line to display wall

OER // ENGINEERING

WATCH FLOOR LAYOUT, SITE A

DRAWING NO.	REV	SHEET
FLR-002	B	1 OF 1

DRAWN	CHECKED	APPROVED
M. KEENE	V. HALE	M. VOSS

DATE	SERIES
15 JUN 1998	FACILITY

CONTROLLED DOCUMENT // CUSTODIAN: ENGINEERING / MAINTENANCE // DO NOT SCALE