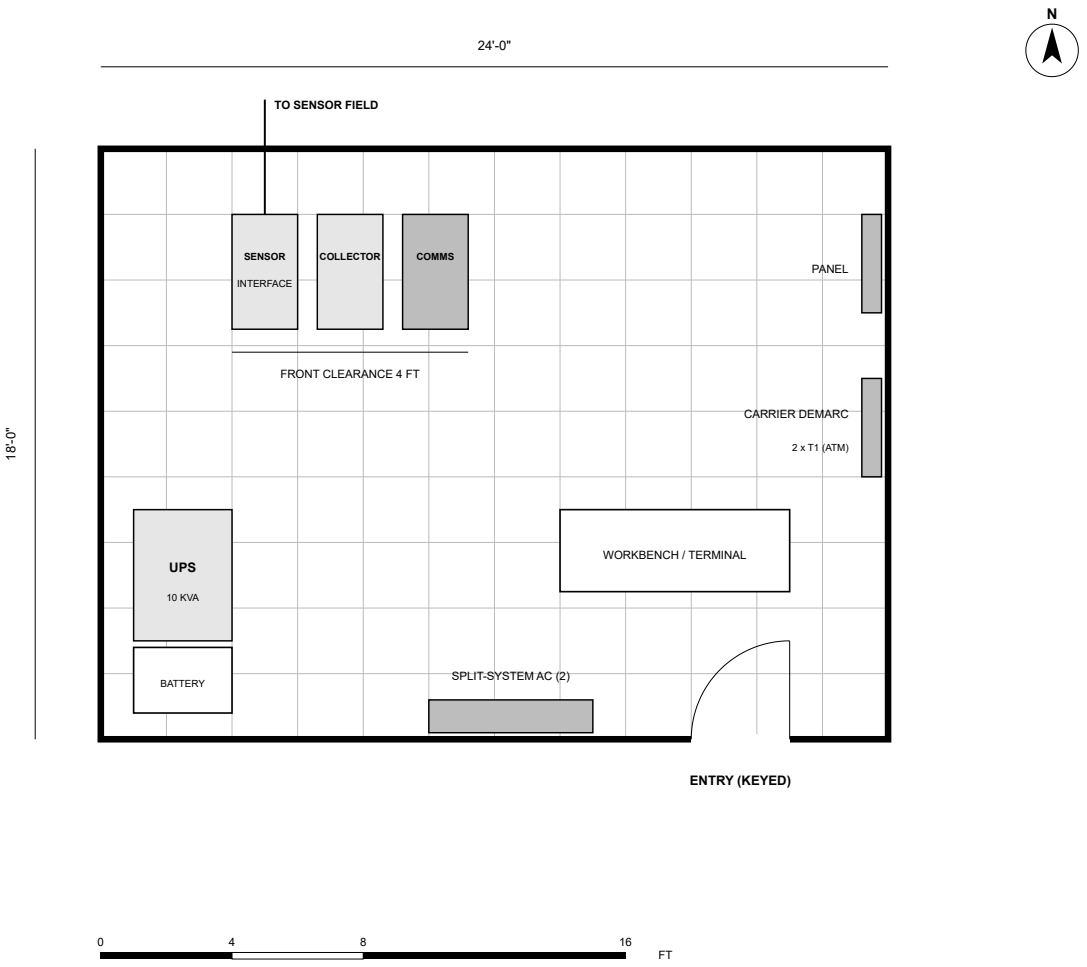


PLAN VIEW, TYPICAL NODE // SCALE: 1/4 IN = 1 FT (NOMINAL)

SUPERSEDED
SEE REGISTER FOR CURRENT REVISION

REVISIONS

REV	DATE	DESCRIPTION	BY	APPR
B	01 JUN 1998	As built, all eight nodes.	NB	MV
A	07 NOV 1996	Initial issue. Collector room, sensor interface rack, communications rack, UPS.		

NOTES

1. All eight nodes (N1-N8) built to this layout. Site differences recorded in the node logbook.
2. Collector room in leased or owned space near the regional sensor field. Sensor field cabling enters at the north wall.
3. Racks: sensor interface, collector, communications. Equipment per INV-002.
4. Communications rack: 2 x T1 (ATM) link to Site A (NET-002).
5. UPS 10 kVA, at least 4 h at node load. No generator; utility outage longer than the UPS is recovered from the node spool.
6. Unstaffed. Visits by Site A engineering per the maintenance schedule.

LEGEND

- Rack / equipment
- Communications / wall panel

OER // ENGINEERING

REGIONAL NODE STANDARD LAYOUT (N1-N8)

DRAWING NO.	REV	SHEET
NODE-001	B	1 OF 1

DRAWN	CHECKED	APPROVED
N. BELL	V. HALE	M. VOSS

DATE	SERIES
01 JUN 1998	SITES

CONTROLLED DOCUMENT // CUSTODIAN: ENGINEERING / MAINTENANCE // DO NOT SCALE