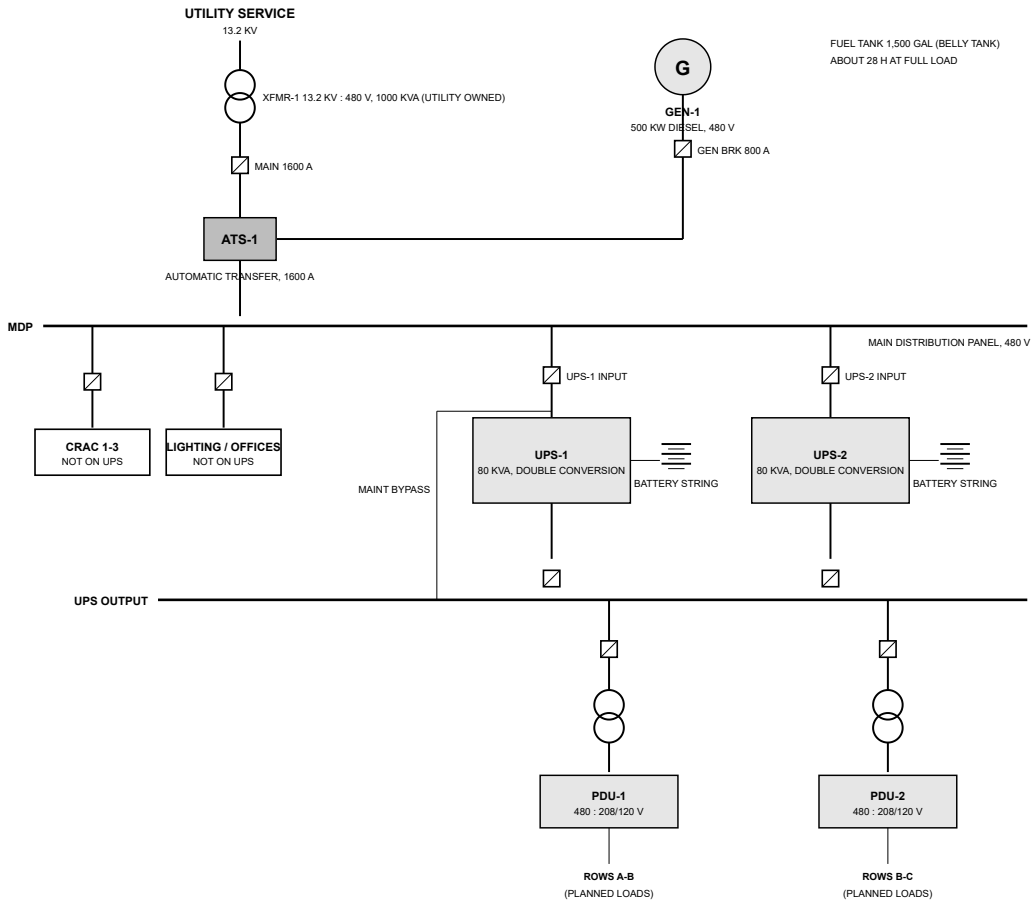


ONE-LINE DIAGRAM. NOT TO SCALE. CABLE SIZES PER PANEL SCHEDULES.

ONE-LINE DIAGRAM // SCALE: NONE

SUPERSEDED
SEE REGISTER FOR CURRENT REVISION

REVISIONS

REV	DATE	DESCRIPTION	BY	APPR
B	30 JUN 1997	As built. Distribution circuits for rows A-C.	MK	MV
A	03 SEP 1996	Initial issue. Utility feed, 500 kW diesel generator, automatic transfer switch, 2 x 80 kVA UPS.		

NOTES

1. Utility service 13.2 kV, transformer owned by the utility. Service entrance 480 V, 1600 A.
2. Standby generator 500 kW diesel. Automatic start on loss of utility; ATS-1 transfers within 10 s.
3. Fuel: 1,500 gal belly tank, about 28 h at full load.
4. UPS: 2 x 80 KVA. Battery runtime at least 10 min at full load.
5. Cooling units, lighting and offices on generator-backed power, not on UPS.
6. Each cabinet fed from two PDUs (A and B side). Positions per FLR-001.
7. Row loads shown for the planned rows A-C.
8. Emergency power off (EPO) at the machine room entry trips all UPS outputs and cooling.

LEGEND

- Generator
- Circuit breaker
- Transformer
- Bus
- Transfer switch / switchgear
- Future / provision only

NEXUS // ENGINEERING

POWER ONE-LINE DIAGRAM, SITE A

DRAWING NO.	REV	SHEET
PWR-001	B	1 OF 1

DRAWN	CHECKED	APPROVED
M. KEENE	V. HALE	M. VOSS

DATE	SERIES
30 JUN 1997	POWER

CONTROLLED DOCUMENT // CUSTODIAN: ENGINEERING / MAINTENANCE // DO NOT SCALE